


BATHS RESERVED FOR COASTAL CLASSIC

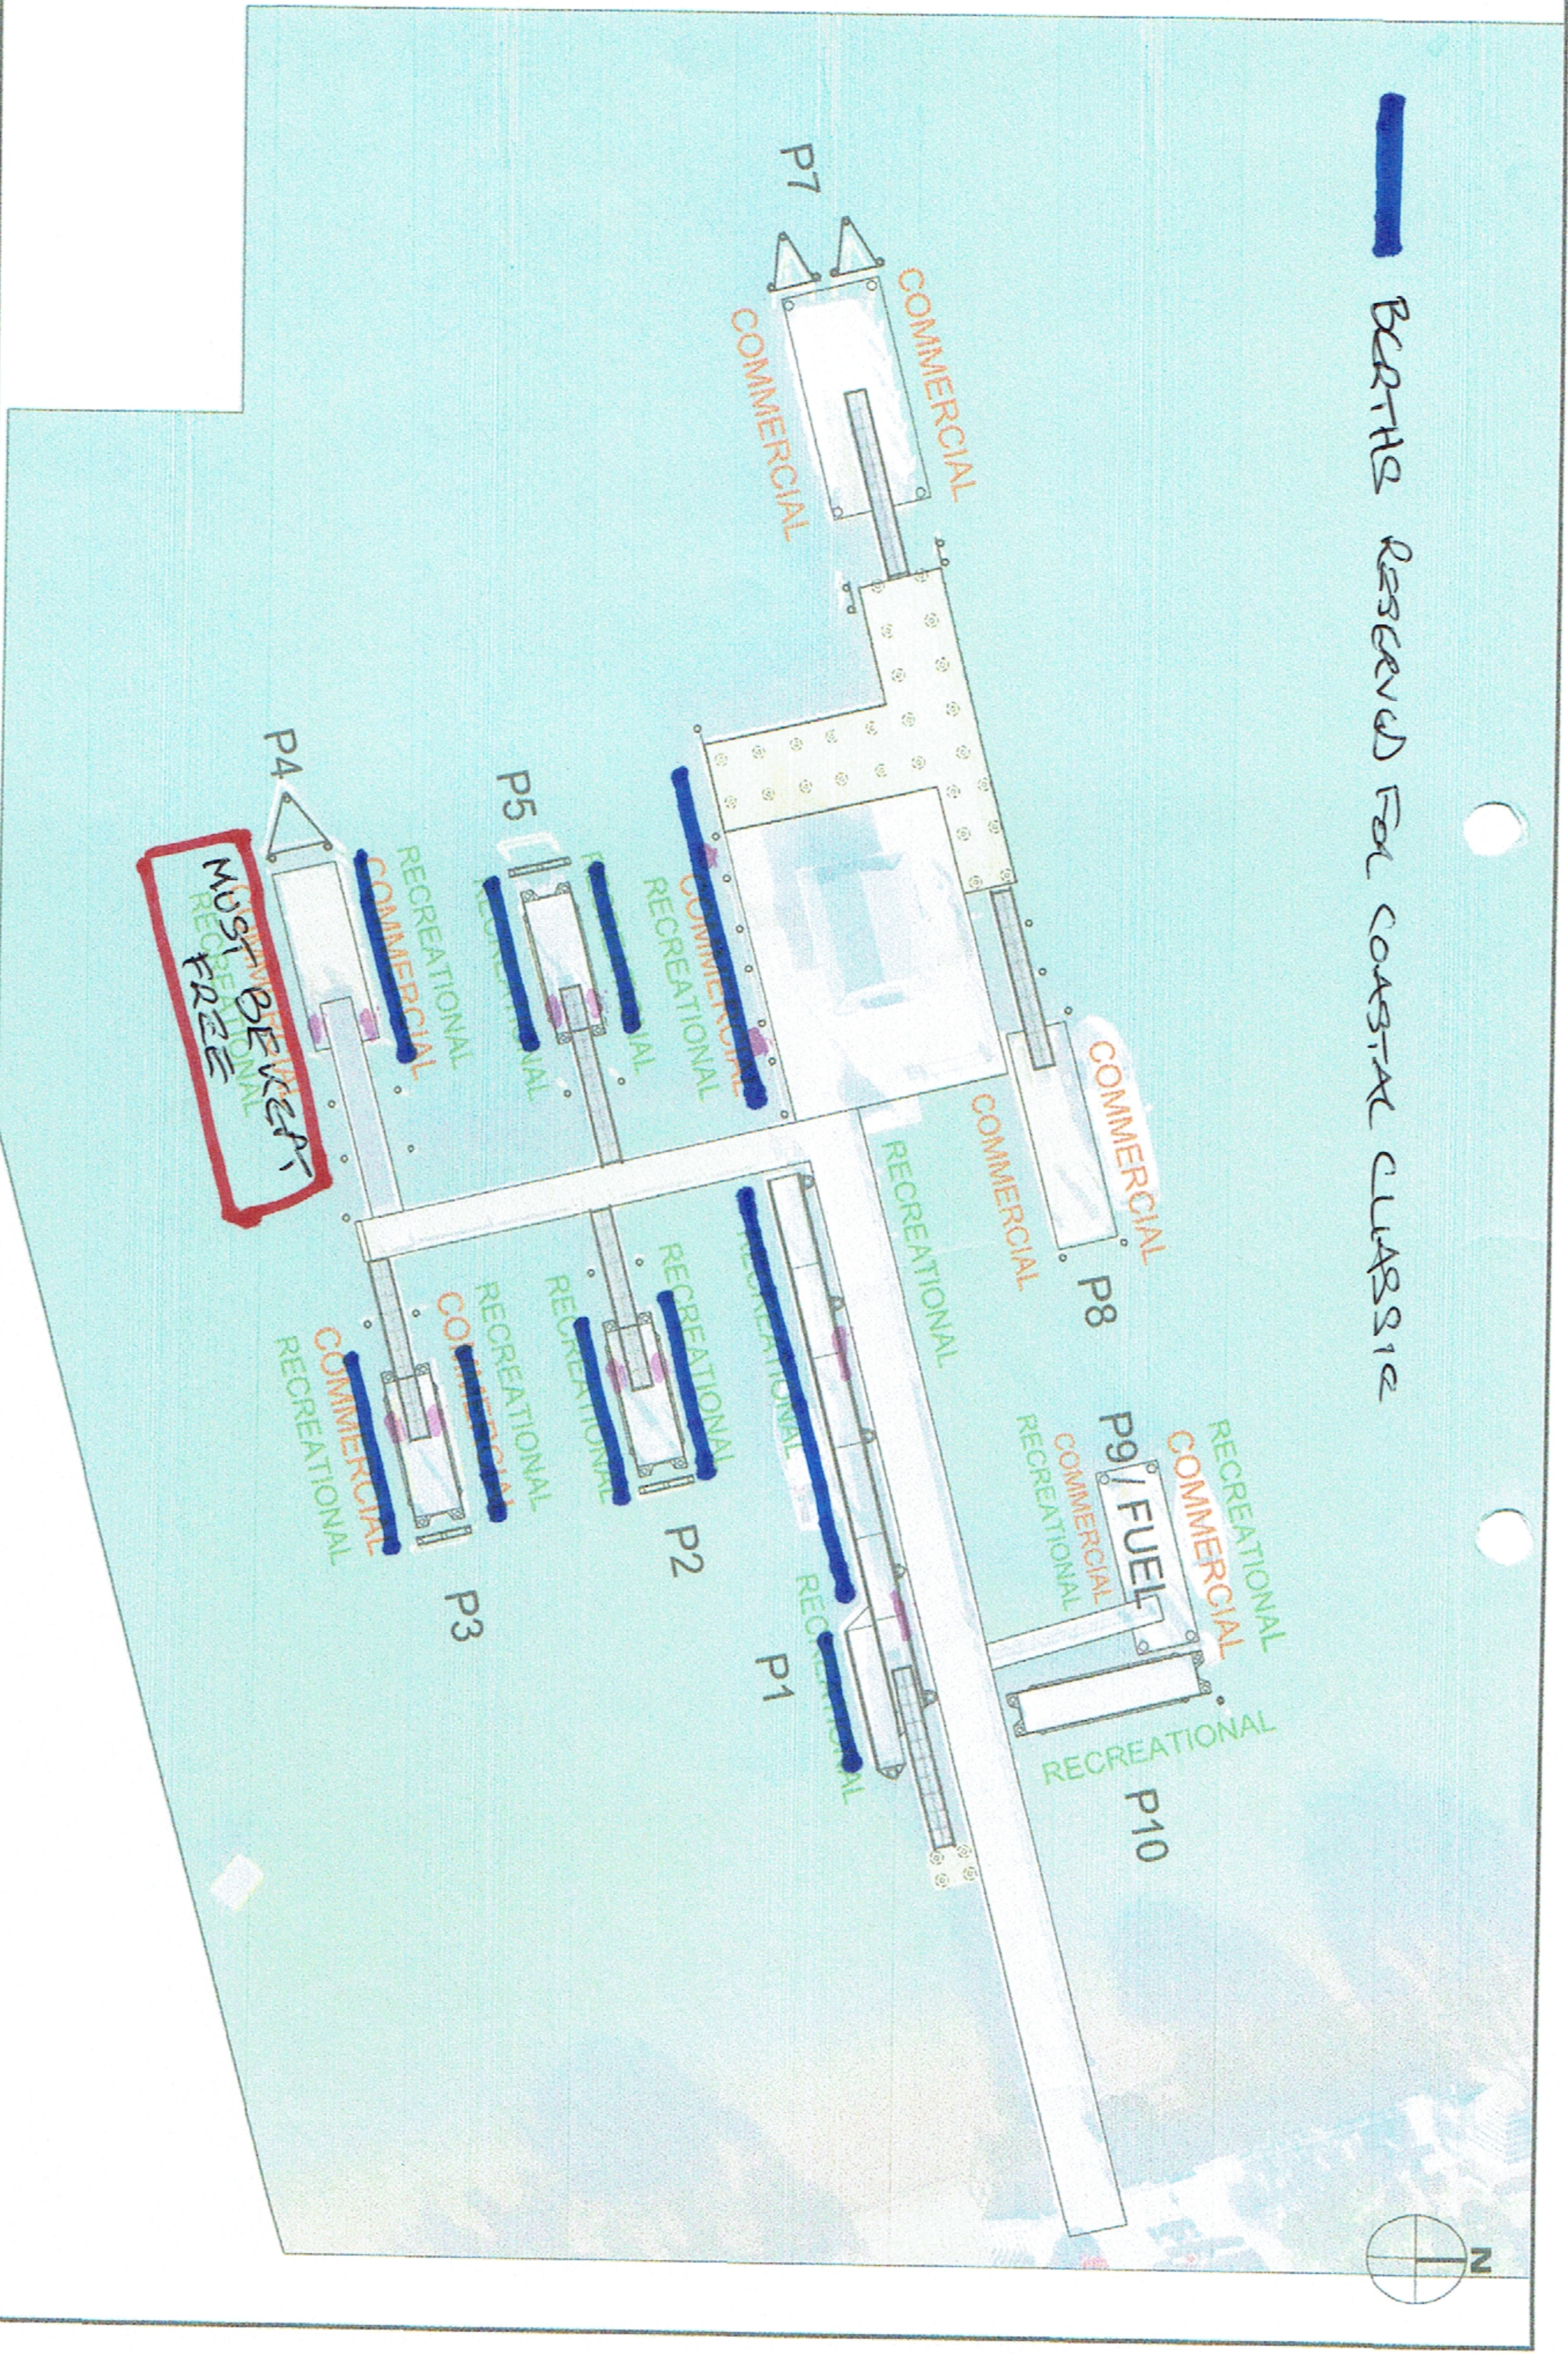

0	AS BUILT ISSUE	04.10.2019
F	AS BUILT ISSUE	03.10.2018
E	AS BUILT ISSUE	01.09.2018
D	CONSTRUCTION ISSUE	24.05.2018
C	AMENDED PLATFORM LOCATION	17.06.2018
B	AMENDED PLATFORM LOCATION	11.04.2018
A	REVISION DETAILS	DATE

DESIGN	DATE: 03/07/18	CONTRACT NO:
DESIGNER	DATE: 03/07/18	CONTRACT NO:
CHECKED	DATE: 03/07/18	CONTRACT NO:
SCALE	DATE: 03/07/18	CONTRACT NO:
CAD FILE NAME	DATE: 03/07/18	CONTRACT NO:

Bellingham
MARINE
THE WORLD'S MOST COMPREHENSIVE MARINA BUILDER

JOB TITLE:
RUSSELL WHARF DEVELOPMENT
VARIOUS WHARF UPGRADES
FAR NORTH

DAVIS COASTAL CONSULTANTS
COASTAL MANAGEMENT AND ENGINEERING
P.O. Box 185
Orawa
Phone: 08 428 0040
Mobile: 021 627 100
Fax: 08 428 0042
Email: coastal@davisconsult.co.nz

DRAWING TITLE	1821
AS BUILT LAYOUT PLAN	
REV	02
DATE	G